


Blue Heron Technology Center

Suite 150
5,453 RSF
Available

As-Built
Space Plan

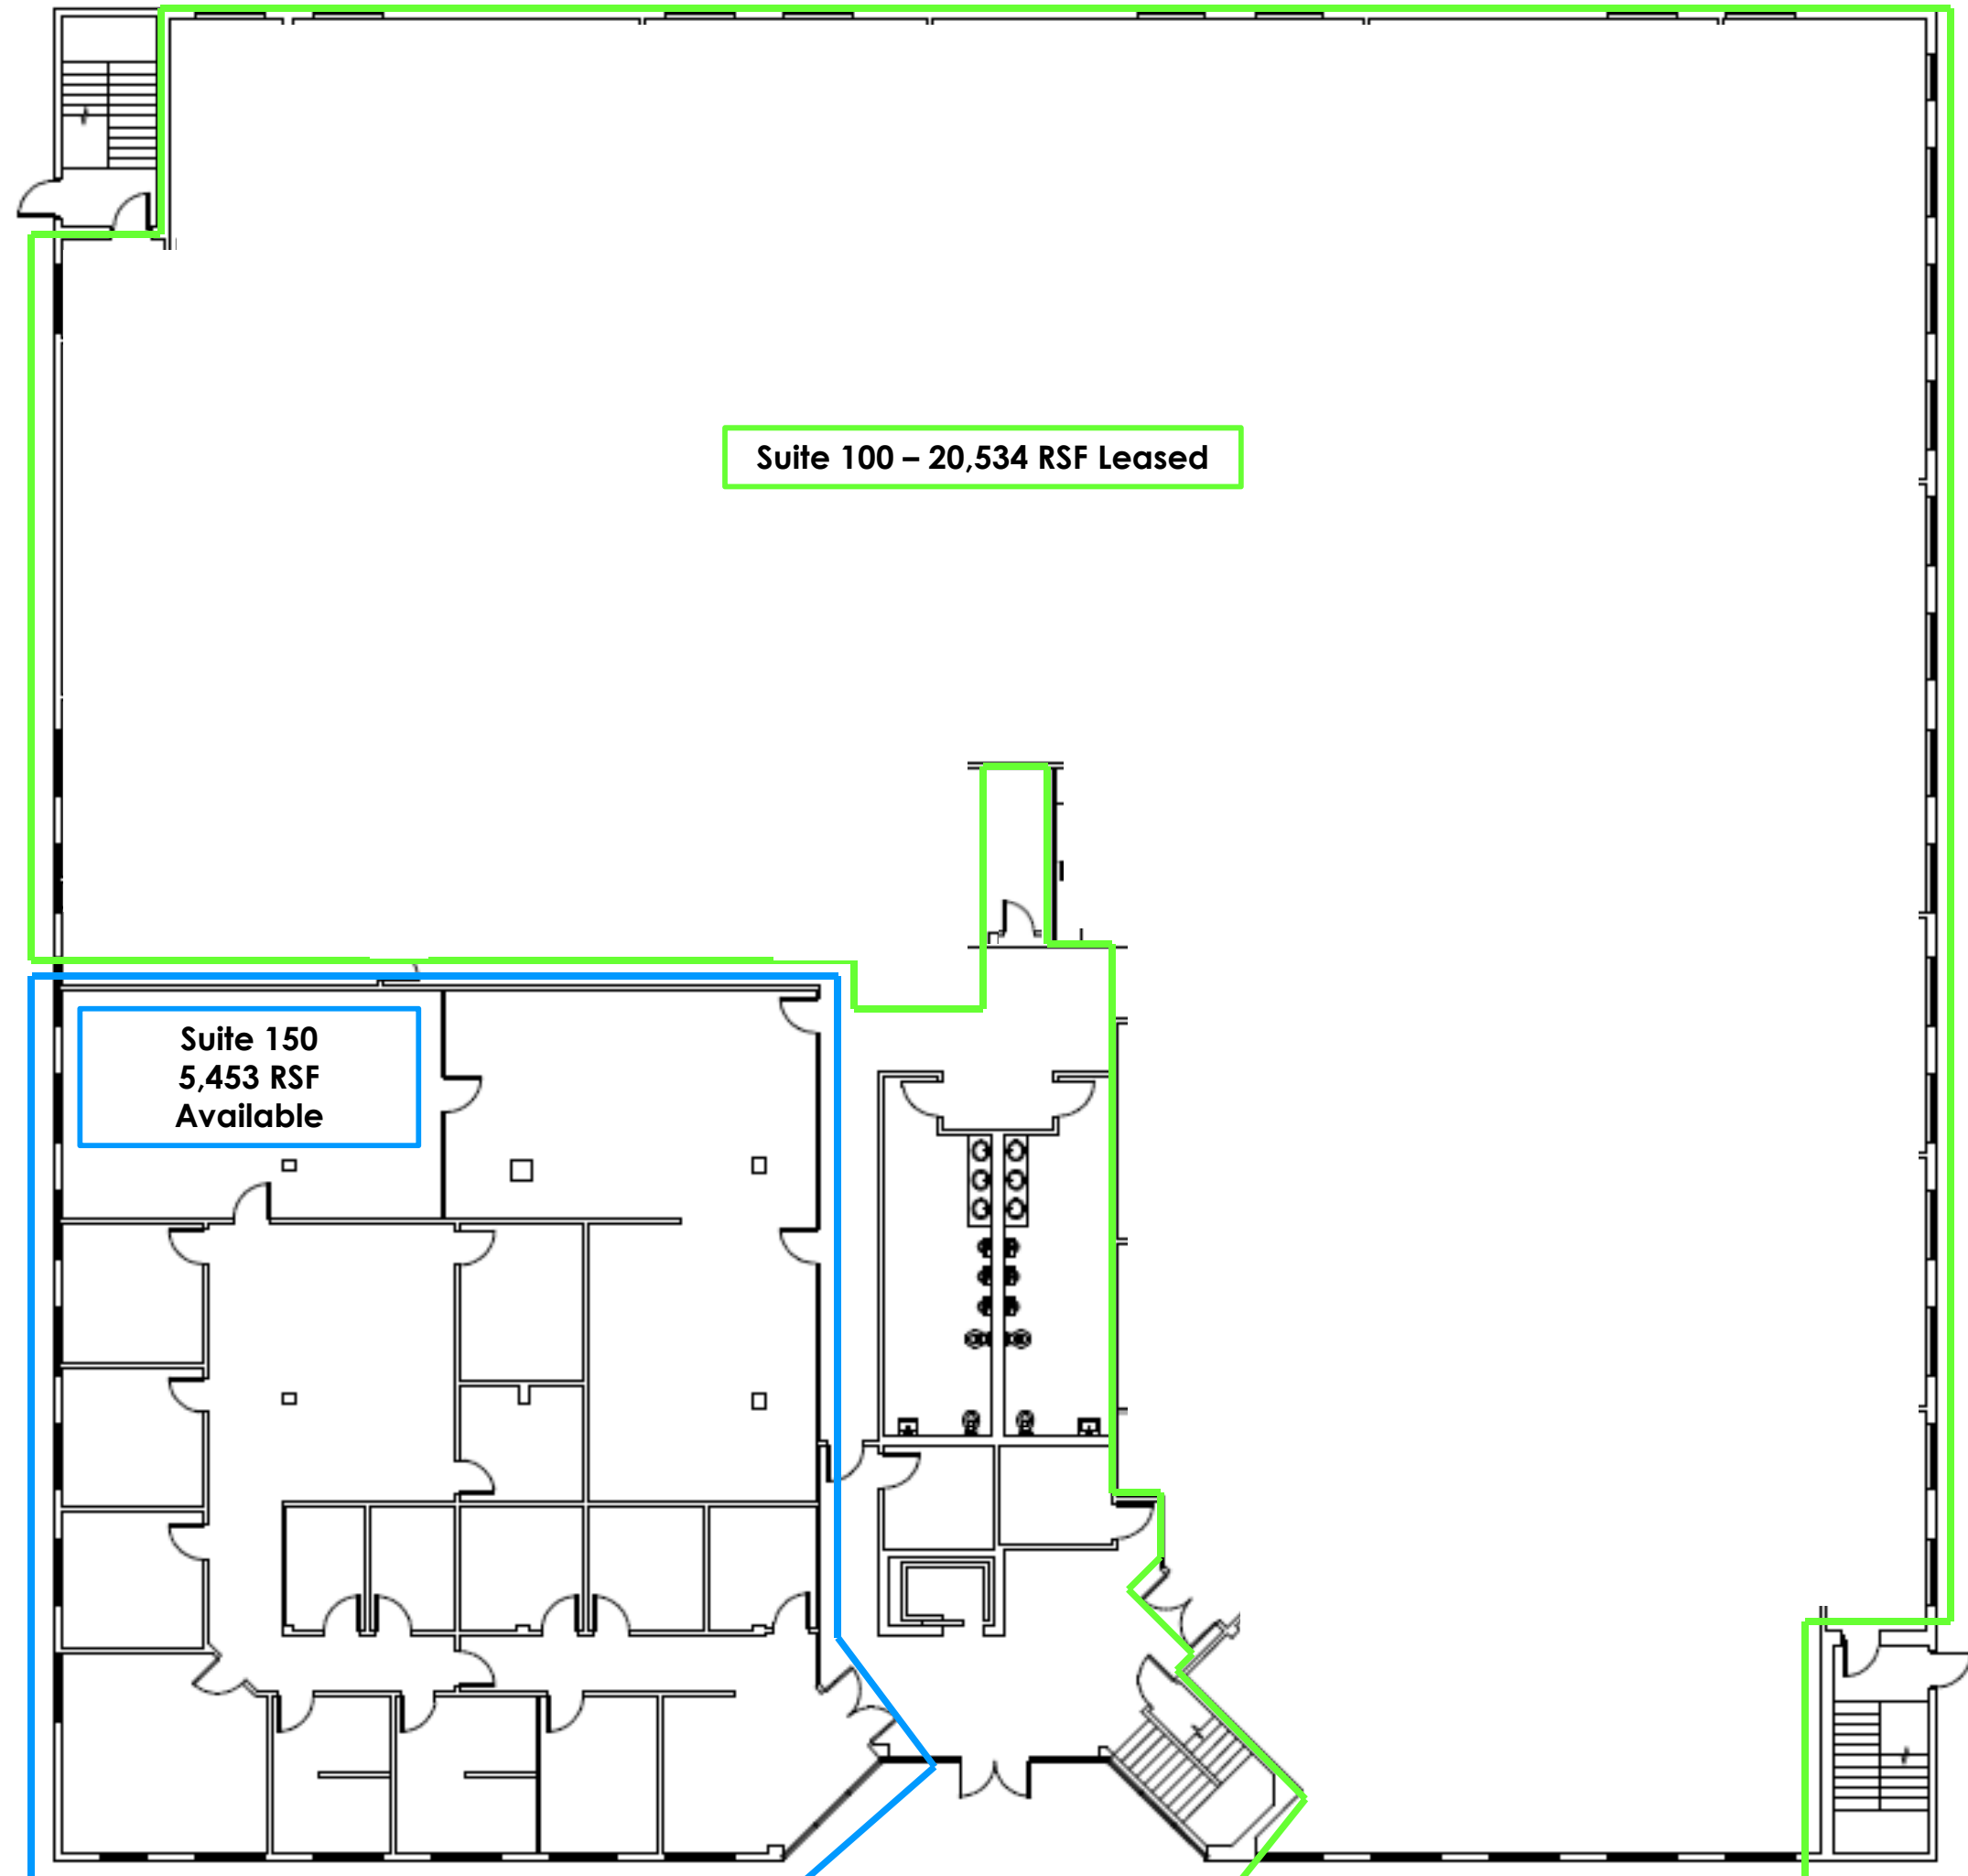

*For More Information,
Please Contact:*

Michael S. Talmadge
727.214.4650
mtalmadge@echelonre.com
www.eresproperties.com

