


Blue Heron Technology Center

**Suite 200
10,263 RSF
Available**

**As-Built
Space Plan**

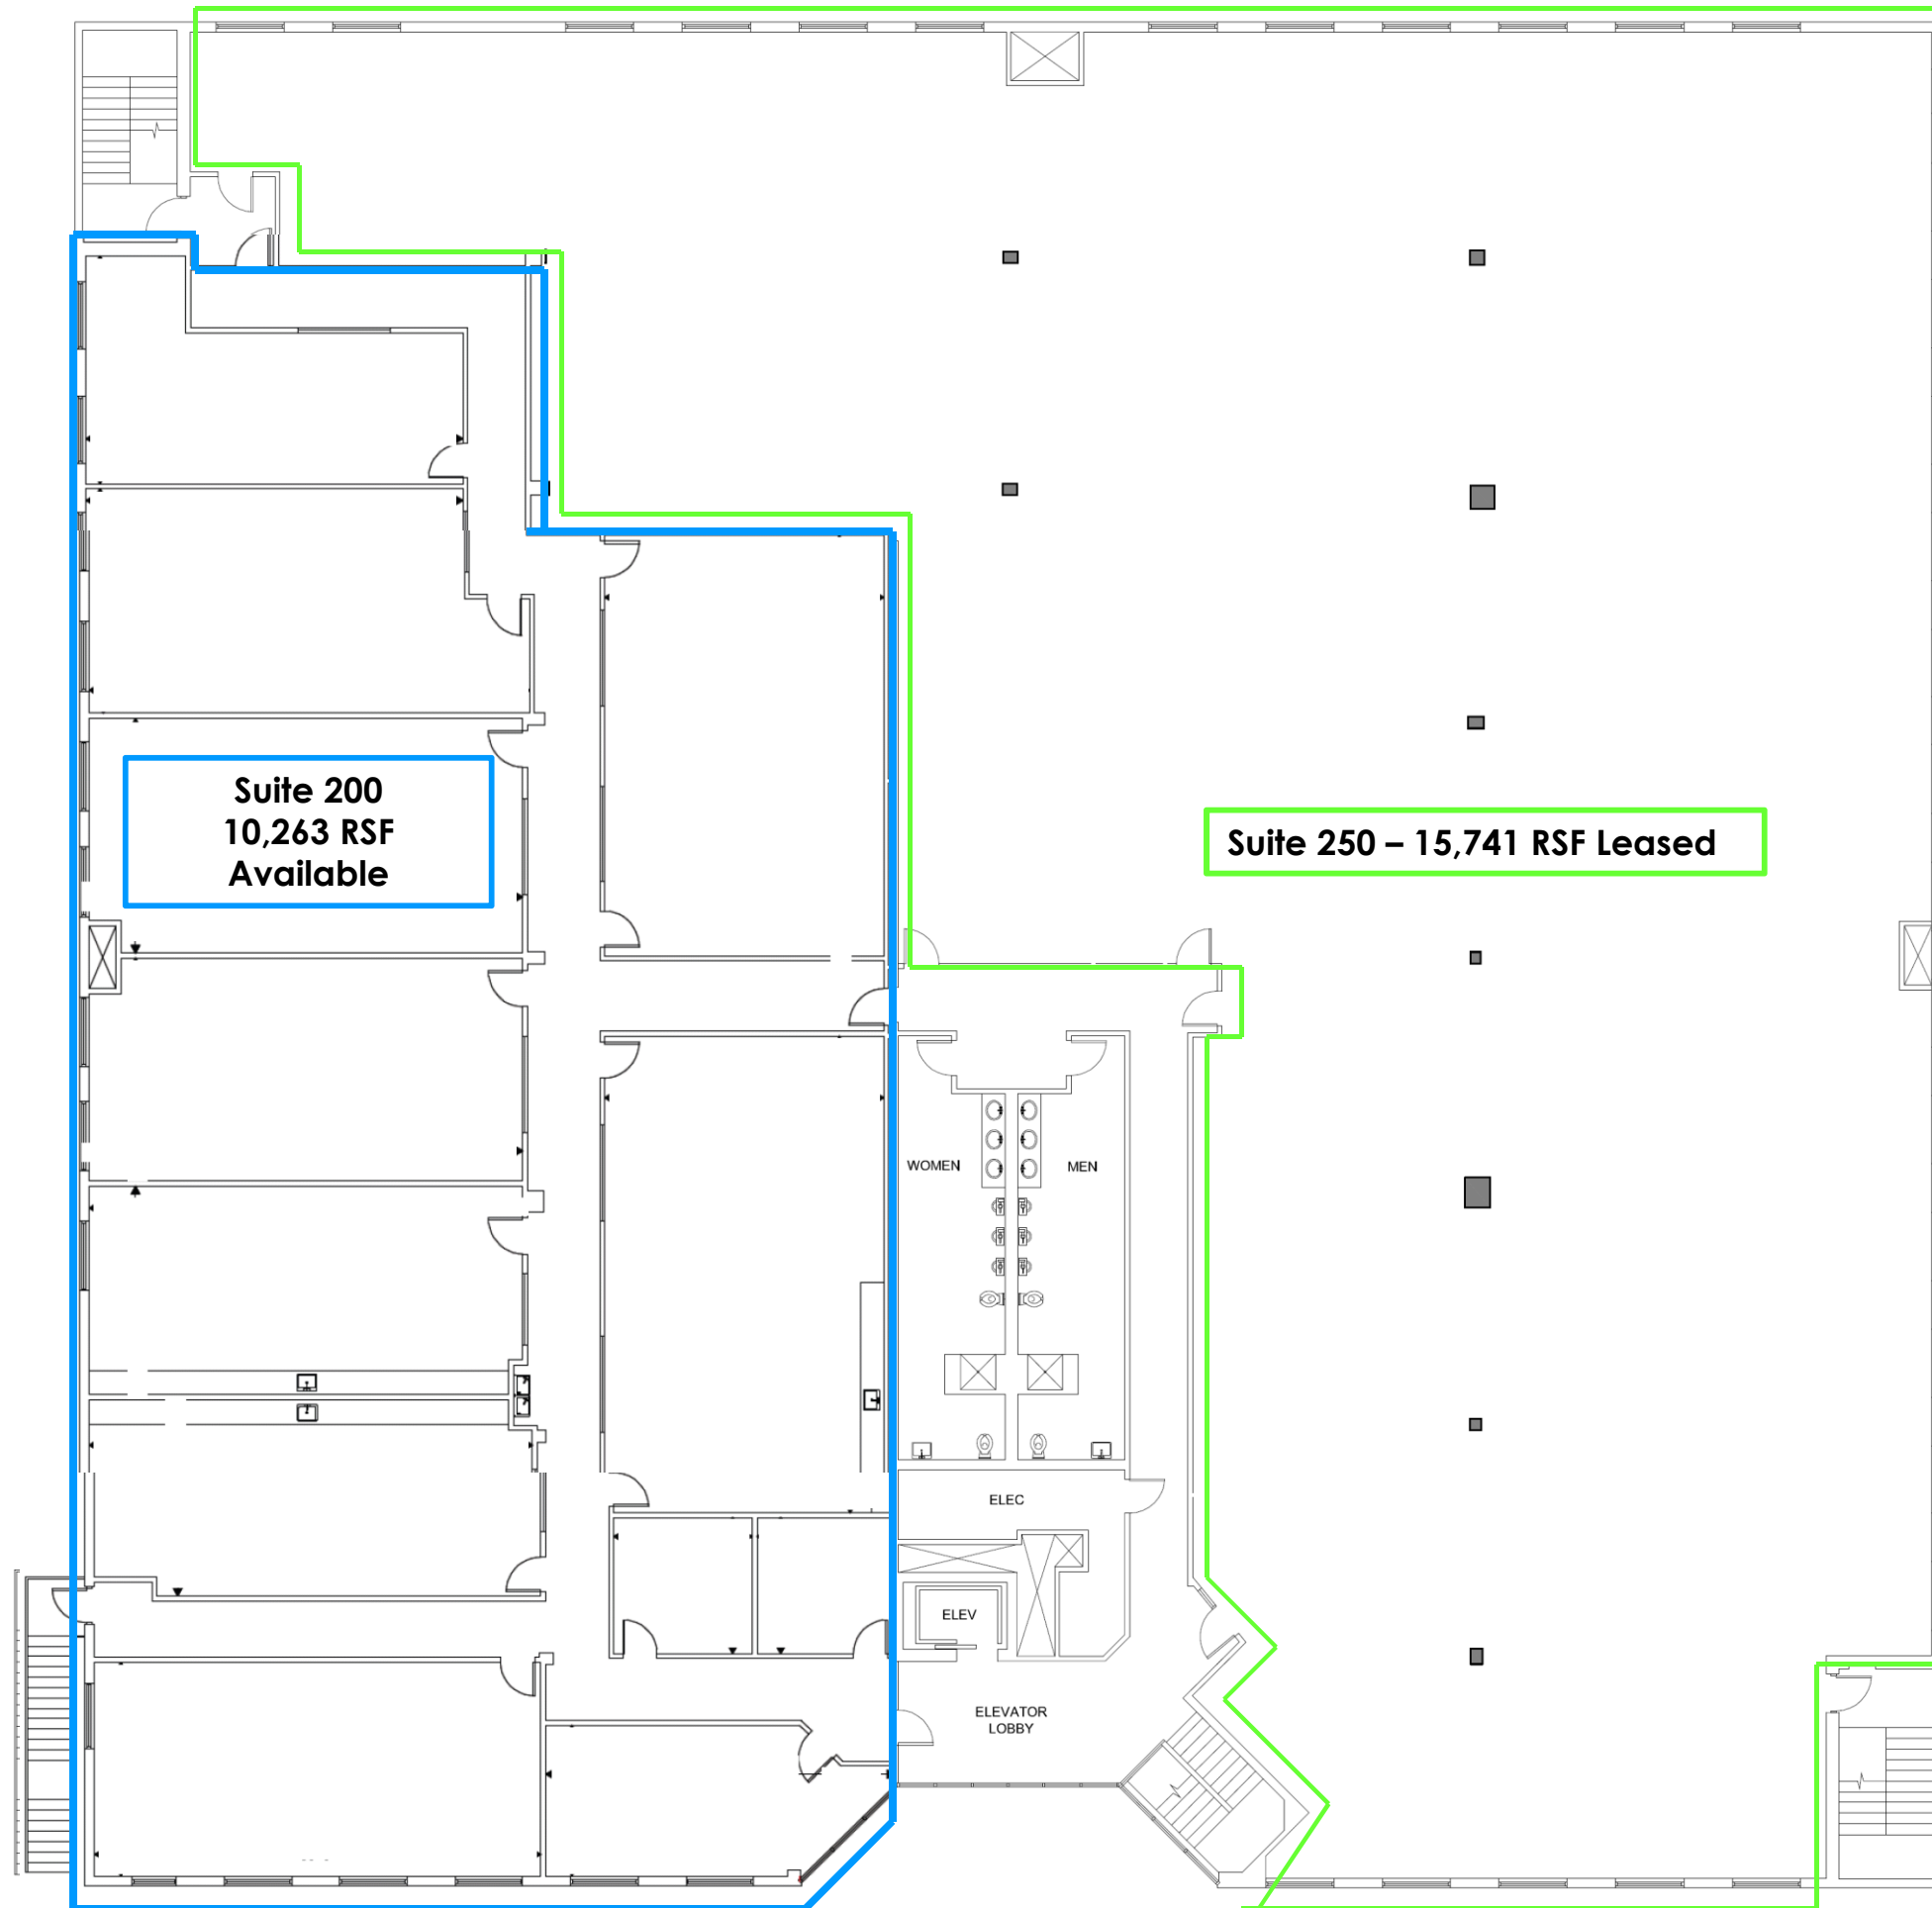

**Suite 200
10,263 RSF
Available**

Suite 250 – 15,741 RSF Leased

*For More Information,
Please Contact:*

Michael S. Talmadge
727.214.4650
mtalmadge@echelonre.com
www.eresproperties.com