


**FRANKLIN TEMPLETON CENTER I**  
**140 Fountain Parkway, St. Petersburg, FL 33716**

**Suite 210**

**“Plug & Play” Space Available: 5,961 RSF**

**As-Built Layout**

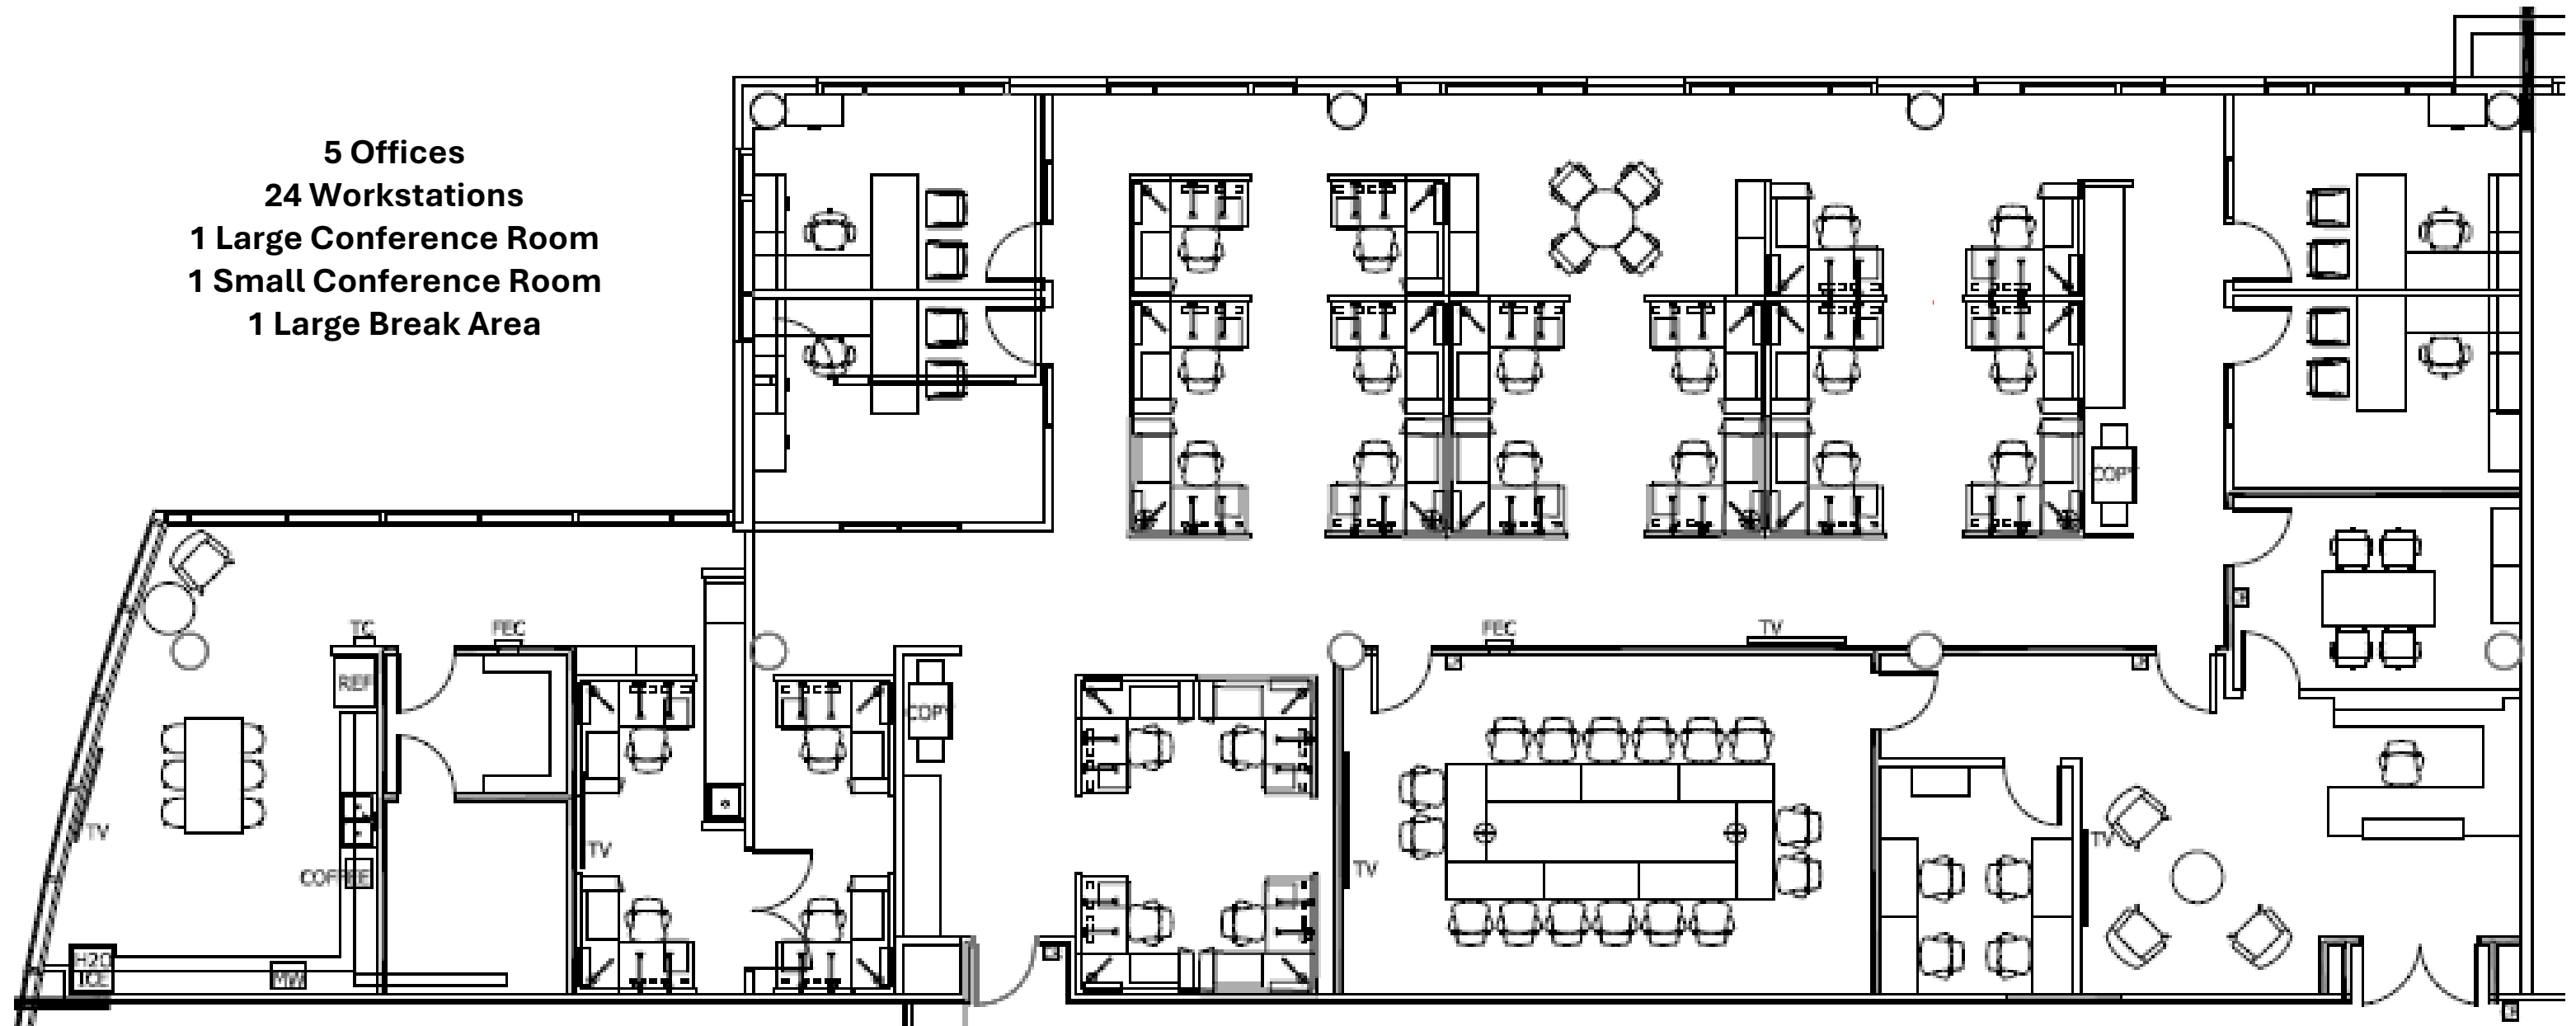

**For More Information, Please Contact:**

**MICHAEL S. TALMADGE**  
**mtalmadge@echelonre.com**  
**727.214.4650**

