


# THE JAMES MUSEUM

150 Central Avenue  
St. Petersburg, FL 33701

16,988 RSF  
Available

## As-Built Layout:

- 17 Offices
- 60 Workstations
- 1 Small Conference Room
- 1 Large Conference Room

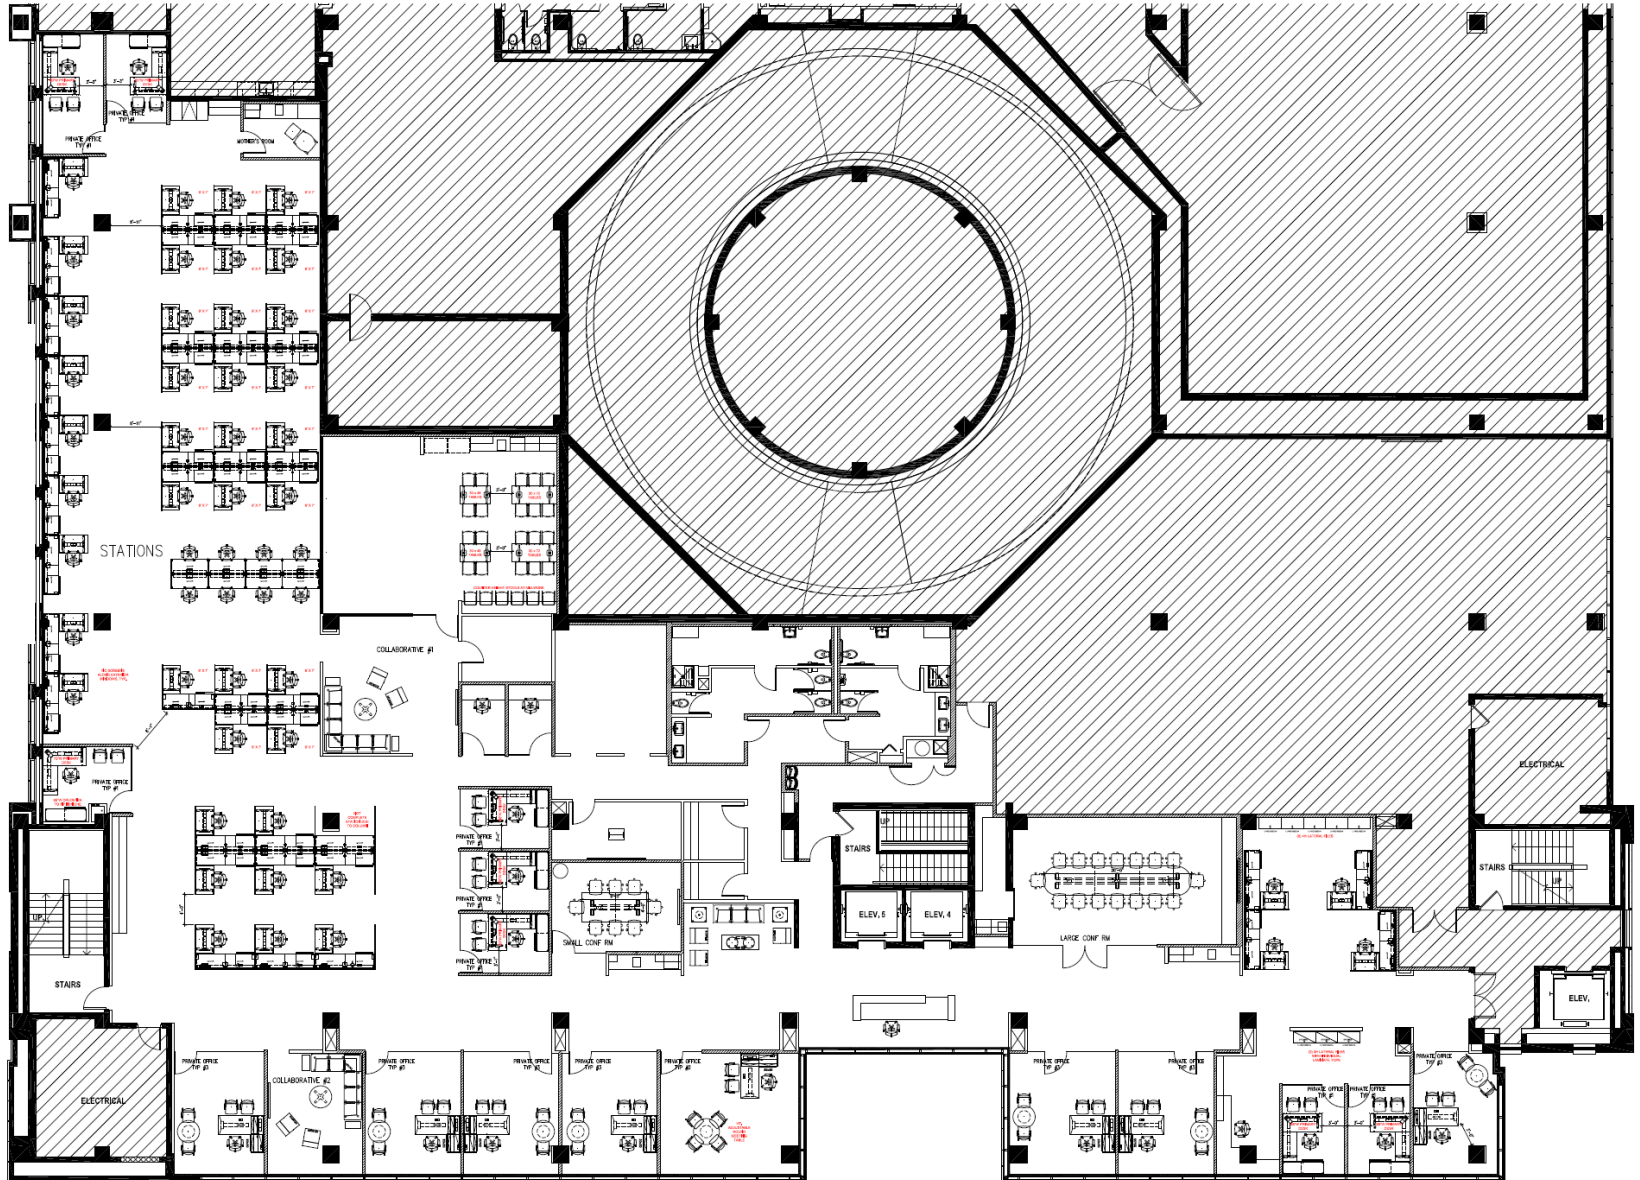

**For More Information Please Contact:**

**Michael S. Talmadge**  
[mtalmadge@echelonre.com](mailto:mtalmadge@echelonre.com)

**727.214.4650**

[www.eresproperties.com](http://www.eresproperties.com)

**ECHELON**



Echelon Real Estate Services, LLC  
Licensed Real Estate Broker