


Roosevelt III – 3RD Floor – 54,912 RSF

Gateway Submarket - 11101 Roosevelt Blvd, St. Petersburg, FL 33716

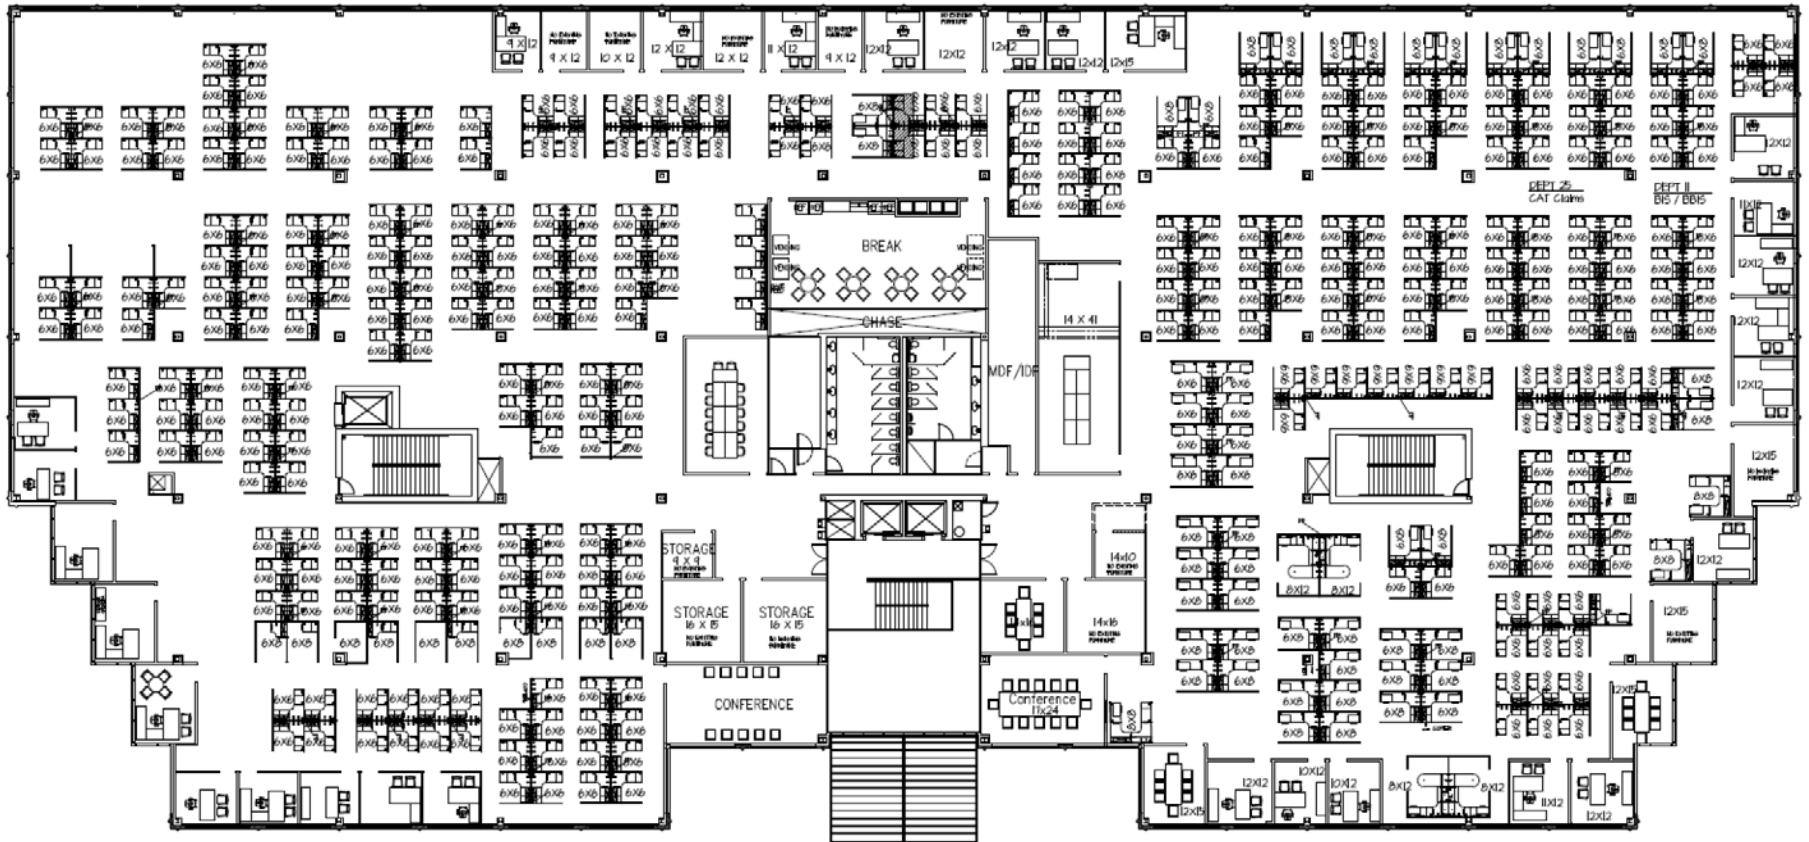

1 3RD FLOOR AS-BUILT PLAN
SCALE: NTS

Offices
 16 12x12 Offices
 5 10x12 Offices
 5 11x12 Offices
 6 12x15 Offices
 + 3 9x12 Offices
35 Total Offices

Workstations
 53 6x8 Standard Workstations
 347 6x6 Standard Workstations
 3 8x8 Standard Workstations
 + 4 8x12 Management Workstations
407 Total Workstations

Conference / Training Rooms
 1 17x24 Room
 2 12x15 Rooms
 + 2 16x30 Rooms
5 Total Conference / Training Rooms

442 Total Headcount (Offices & Workstations)

For More Information:

MICHAEL S. TALMADGE
 mtalmadge@echelonre.com
 727.214.4650

