


Roosevelt III – 4th Floor – 54,912 RSF

Gateway Submarket - 11101 Roosevelt Blvd, St. Petersburg, FL 33716

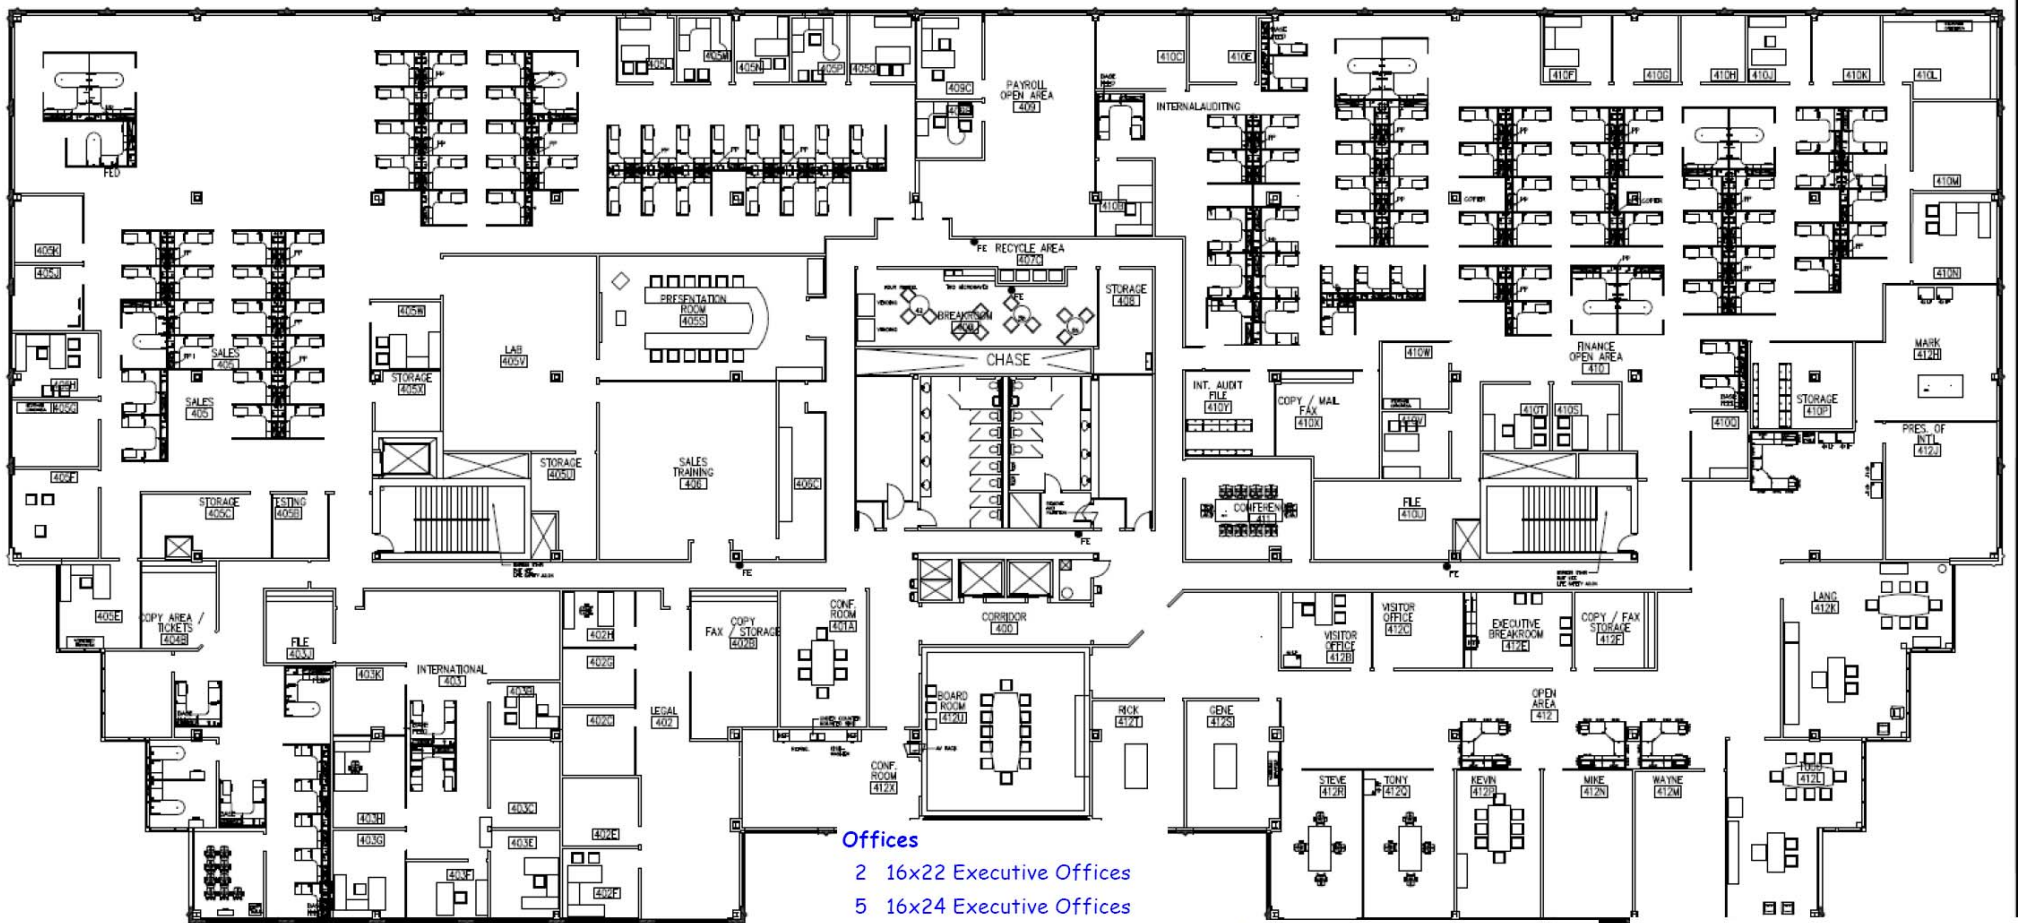

1 4TH FLOOR AS-BUILTS
SCALE: NTS

186 Total Headcount (Offices & Workstations)

- Offices**
- 2 16x22 Executive Offices
 - 5 16x24 Executive Offices
 - 3 18x26 Executive Offices
 - 14 11x12 Offices
 - 12 12x12 Offices
 - 5 12x15 Offices
 - 10 9x12 Offices
 - + 4 10x12 Offices
 - 55 Total Offices**

- Workstations**
- 92 6x8 Standard Workstations
 - 9 6x6 Standard Workstations
 - 14 8x8 Standard Workstations
 - 4 8x8 Executive Workstations
 - + 12 8x12 Management Workstations
 - 131 Total Workstations**

- Conference / Training Rooms**
- 2 16x30 Rooms
 - 2 32x32 Rooms
 - 1 12x15 Room
 - + 1 16x18 Room
 - 6 Total Conference / Training Room**

For More Information:

MICHAEL S. TALMADGE
mtalmadge@echelonre.com
727.214.4650

